


# Highland Ridge Tower

535 Marriott Drive, Nashville, Tennessee 37214

## Suite 900 – 25,431 rsf

Available November 2017

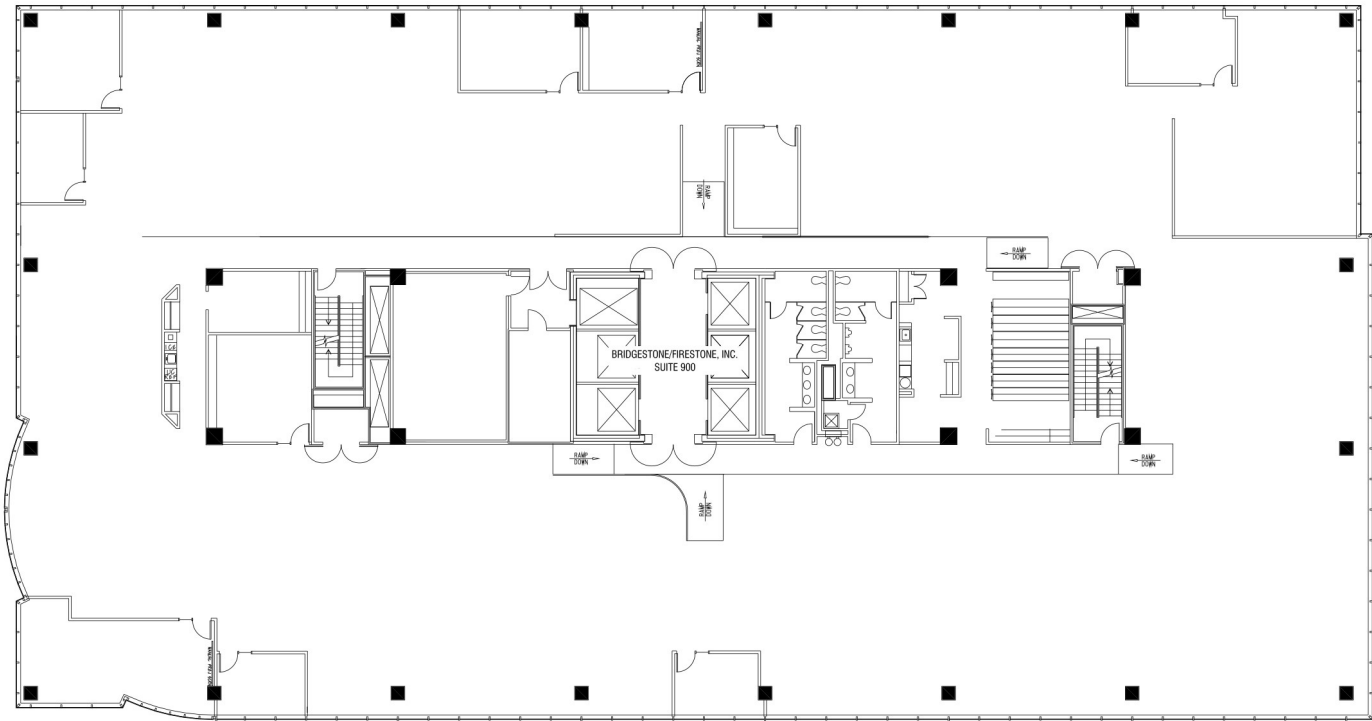

AS BUILT 9TH FLOOR  
16' 8' 0' 16'

### LEASING INFORMATION:

Whit McCrary IV, CCIM 615.301.2908  
whit.mccrary@cushwake.com  
Rob Lowe 615.301.2910  
rob.lowe@cushwake.com

