


Highland Ridge Tower

535 Marriott Drive, Nashville, Tennessee 37214

Suite 1200 – 4,828 rsf

Available November 2017

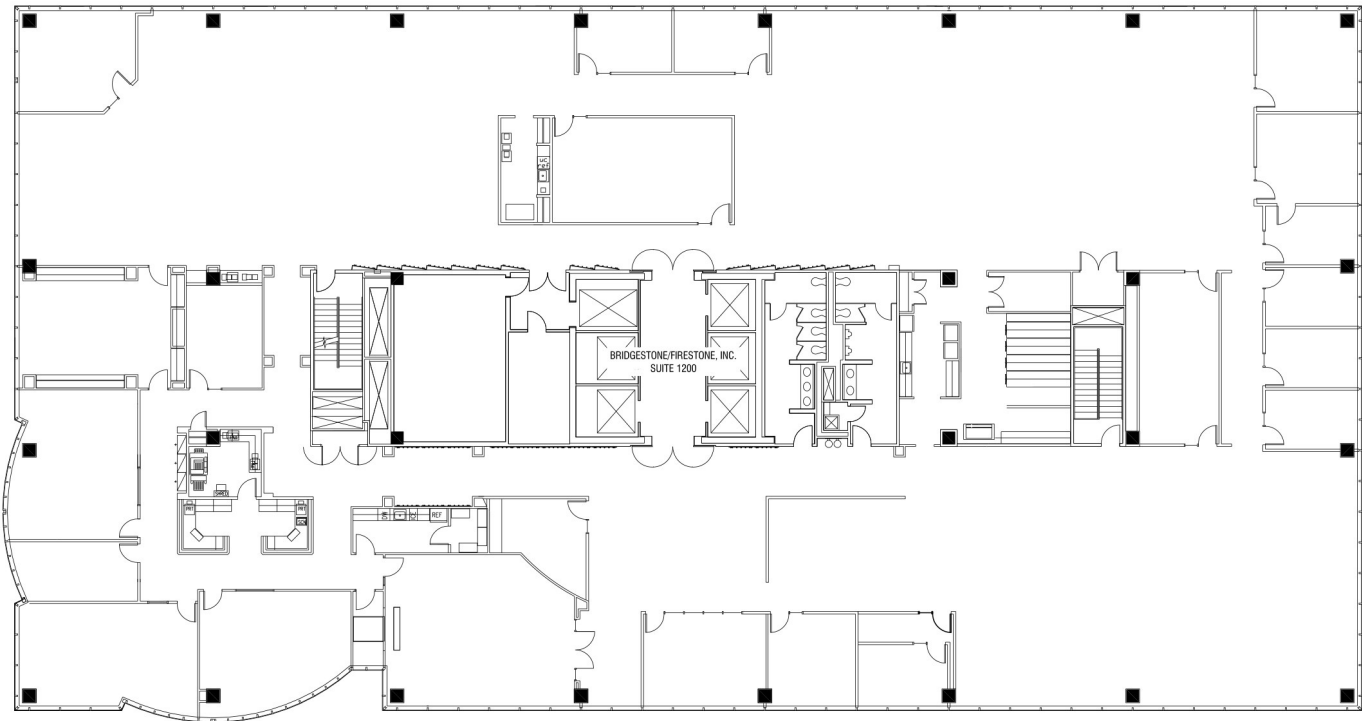

AS BUILT 12TH FLOOR
16' 8' 0' 16'

LEASING INFORMATION:

Whit McCrary IV, CCIM 615.301.2908
whit.mccrary@cushwake.com
Rob Lowe 615.301.2910
rob.lowe@cushwake.com

